



1 PROPOSED NURSERY FLOOR PLAN
Scale 1:100

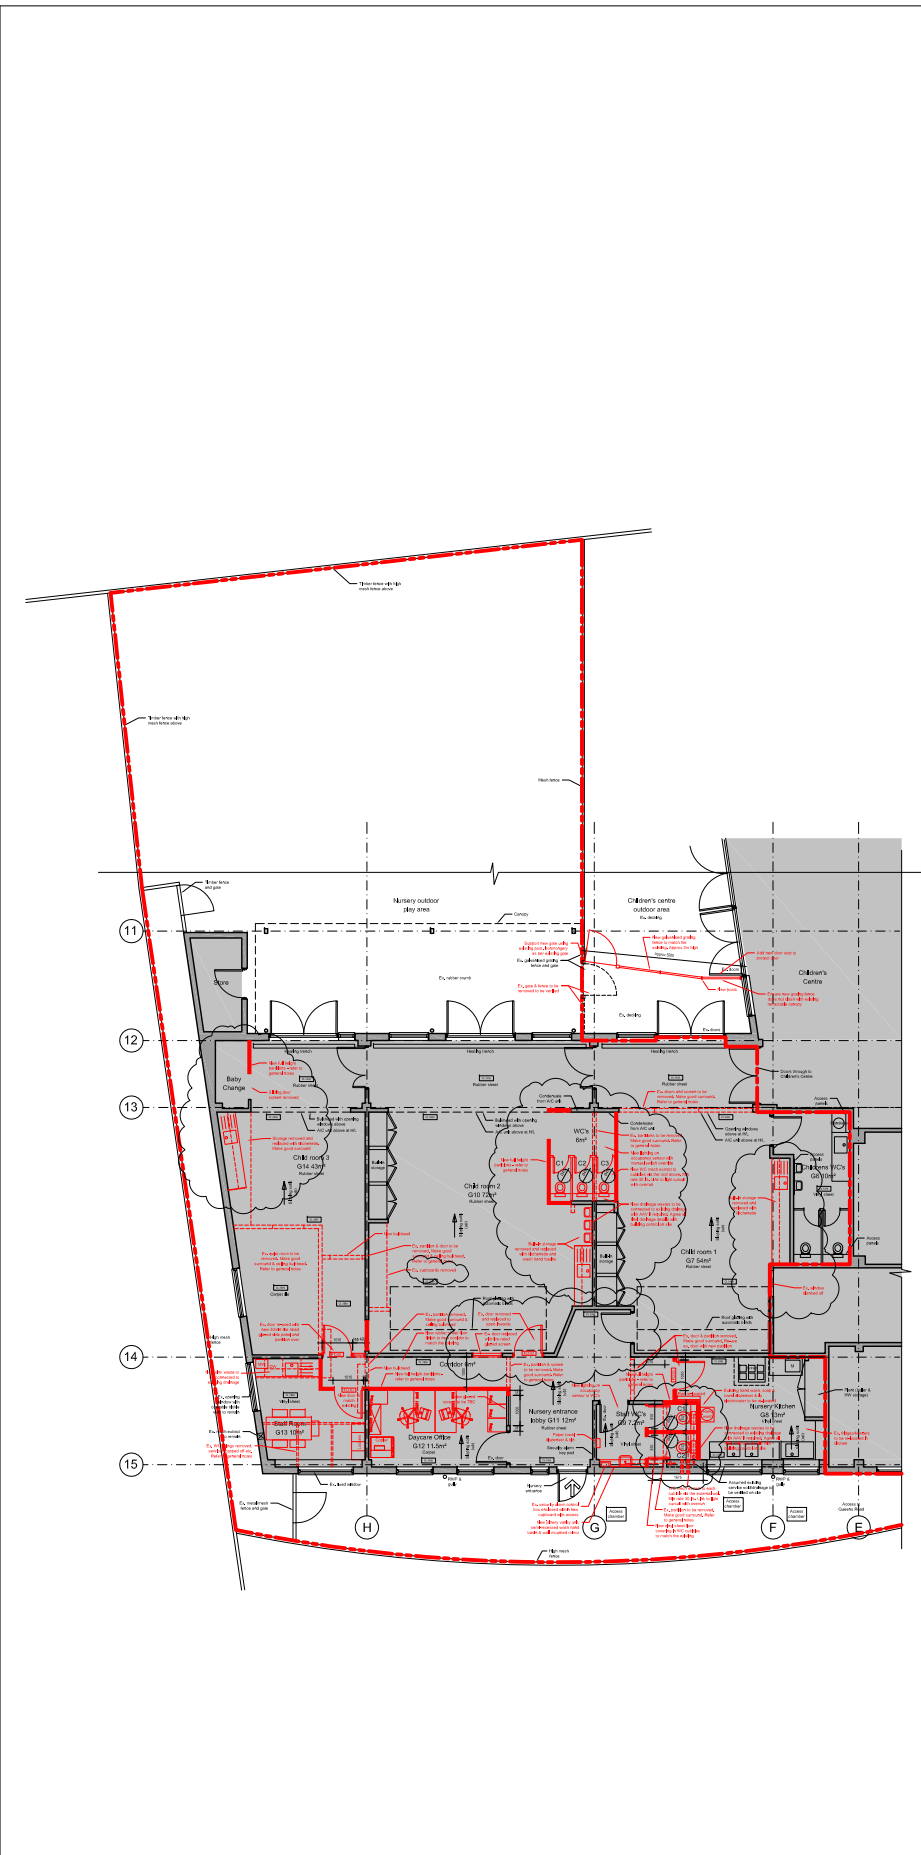

2 PROPOSED NURSERY FLOOR PLAN
Scale 1:250

Status
THE AUTHOR TAKES NO RESPONSIBILITY FOR ANY DIMENSIONS OBTAINED BY SCALING FROM THIS DRAWING. IF NO DIMENSION IS SHOWN THE RECIPIENT MUST ASCERTAIN THE DIMENSION SPECIFICALLY FROM THE ARCHITECT OR BY SITE MEASUREMENT AND MAY NOT RELY UPON THIS DRAWING. SUPPLYING THIS DRAWING IN DIGITAL FORM IS SOLELY FOR CONVENIENCE AND NO RELIANCE IS TO BE PLACED ON ANY DATA ON DIGITAL FORM. ALL DATA MUST BE CHECKED AGAINST THE HARD COPY.

Revisions
Rev A - 20/04/17: Client comments updated
Rev B - 16/05/17: Building control comments updated
Rev C - 04/11/17: Record drawings. Updated to client's comment.

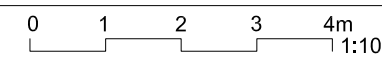

Client	Mr C. Sheen
Project	215 Queens Road, London E17 8PJ
Title	PROPOSED NURSERY FLOOR PLAN
Dwg No.	273_PR_01
Rev	C
Scale	1:100 @ A3 1:50 @ A1
Date	March 17

HARDCASTLE ARCHITECTS
33 Lockhurst Street
London E5 0AP
t 020 8533 0995
m 07939 266608
info@hardcastlearchitects.com
www.hardcastlearchitects.com